

Work Order ID 136713

Wednesday, September 02, 2015 2:45:15 PM

136713

^{DAS 9 989}
~~PRELIMINARY ISSUE~~

Page 1

Item ID: D3537-1

Accept

N900040100

Setup Start *NS1*

Revision ID:

Item Name: Wearpad

Stop *NS2*

Start Date: 9/1/2015

Start Qty: 50.00

50

Cust Item ID:

Required Date: 9/1/2015

Req'd Qty: 50.00

50

Customer:

Reference:

Approvals:

Process Plan: MLS

Date: SEP 08 2015

Tooling:

Date:

QC:

Date:

SPC (Y/N):

Date:

Run Start *NR1*

Stop *NR2*

Sequence ID/ Work Center ID	Operation Description	Set Up/ Run Hours	Tool ID	Tool #	Plan Code	Accept Qty	Reject Qty	Reject Number	Insp. Stamp
--------------------------------	--------------------------	----------------------	---------	--------	--------------	---------------	---------------	------------------	----------------

Draw Nbr

Revision Nbr

^{DAS 9 989}
Rev E

D3537

~~D RES~~

9

989 11-13

Rev E

110

FLOW WATER JET

0.00

110

Waterjet

Memo

0.02

FLOW CNC Waterjet

1-Cut D3537-1 as per Dwg D3537

Dwg Rev: ~~D RES~~ PD 11-13

Prog Rev: ~~D RES~~

2-Deburr if necessary

(50)

09/15/2015

120

QC2- Inspect parts off machine FAI/FAIB

0.00

120

QC

Memo

0.01

Quality Control

(50)

09/15/2015

DQA: _____ Date: _____

**WORK ORDER NON-CONFORMANCE / UPDATE**

QA Closed: _____ Date: _____

Work Order update only ☐

Work Order: _____ Part No. _____ NCR No. _____	DISPOSITION Rework ☐ Scrap ☐ Use-as-is ☐ Suspected Unapproved ☒	AGAINST DEPARTMENT/PROCESS <table style="width:100%; border: none;"> <tr> <td style="border: none;">Skid-tube ☐</td> <td style="border: none;">Cross tube ☐</td> <td style="border: none;">Water Jet ☐</td> <td style="border: none;">Engineering ☒</td> </tr> <tr> <td style="border: none;">Machining ☐</td> <td style="border: none;">Small Fab ☐</td> <td style="border: none;">Prod. Eng. Coord. ☐</td> <td style="border: none;">Quality ☐</td> </tr> <tr> <td style="border: none;">Thermoforming ☐</td> <td style="border: none;">Finishing ☐</td> <td style="border: none;">Rec/Store/Packaging ☐</td> <td style="border: none;">Other ☐</td> </tr> <tr> <td style="border: none;">Large Fab ☐</td> <td style="border: none;">Composite ☐</td> <td style="border: none;">Supplier ☐</td> <td></td> </tr> </table>				Skid-tube ☐	Cross tube ☐	Water Jet ☐	Engineering ☒	Machining ☐	Small Fab ☐	Prod. Eng. Coord. ☐	Quality ☐	Thermoforming ☐	Finishing ☐	Rec/Store/Packaging ☐	Other ☐	Large Fab ☐	Composite ☐	Supplier ☐																								
Skid-tube ☐	Cross tube ☐	Water Jet ☐	Engineering ☒	
Machining ☐	Small Fab ☐	Prod. Eng. Coord. ☐	Quality ☐	
Thermoforming ☐	Finishing ☐	Rec/Store/Packaging ☐	Other ☐	
Large Fab ☐	Composite ☐	Supplier ☐	
Date : <u>15.12.01</u>	Step #:	QTY Effective :		MRB (QSI042) Approval <u>A.P.</u> <u>15.12.01</u>	
Description Work Order Deviation		Disposition		Completed By DAS 30 2-89 1/15	
WEARPLATES UPDATED TO USE ROBOTIC WELD		PARTS ACCEPTABLE, TEST FIT PERFORMED BY STEVE DROWN & ALAN STOCKER MANUFACTURE PER ATTACHED APPROVED REV E. (DEFECT APPROVED DWL)		Lead hand Supervisor Approval Verification DAS 9 9-89 <u>15-12-01</u>	
				QC / QA Coordinator Approval DAS 9 9-89 <u>15-12-01</u>	
Root Cause		FAULT CATEGORY	
Environment ☐ Design ☐ Doc/Data ☐ Equip/Tooling ☐ Handling/Pre ☐ Material ☐ Internal Transport ☐ Tribal Knowledge ☐ LOA ☐ Substation ☐ Past Expiry Date ☐ Misidentified ☐	No Re-verification ☐ Operator ☐ Offset/Setup ☐ Supplier ☐ Training ☐ Use for Testing ☐ Poor Information ☐ Rushing ☐ ☒ Product Improvement Process Improvement ☐ Manufacturing Process ☐ Past Due ☐	<table style="width:100%; border: none;"> <tr> <td style="border: none;">Pressure/Forced ☐</td> <td style="border: none;">Temperature/Cure ☐</td> <td style="border: none;">Power Loss/Surge ☐</td> <td style="border: none;">Positioned Wrong ☐</td> </tr> <tr> <td style="border: none;">Bending ☐</td> <td style="border: none;">Set-up ☐</td> <td style="border: none;">Folio/Program ☐</td> <td style="border: none;">Outside Dimensions ☐</td> </tr> <tr> <td style="border: none;">Centre Not Concentric ☐</td> <td style="border: none;">BOM/Route ☐</td> <td style="border: none;">Grain ☐</td> <td style="border: none;">Over/Under tolerance ☐</td> </tr> <tr> <td style="border: none;">Cracks ☐</td> <td style="border: none;">Broken/Damage/Defect ☐</td> <td style="border: none;">Weld ☐</td> <td style="border: none;">Part Incorrect ☐</td> </tr> <tr> <td style="border: none;">Crimp/Kink/Ripple/Wave ☐</td> <td style="border: none;">Inspection Incomplete/Unqualified ☐</td> <td style="border: none;">Wrong Stock Pulled ☐</td> <td style="border: none;">Part Lost/Missing ☐</td> </tr> <tr> <td style="border: none;">Cuffs ☐</td> <td style="border: none;">Contamination ☐</td> <td style="border: none;">Out of Sequence ☐</td> <td style="border: none;">Part Moved ☐</td> </tr> <tr> <td style="border: none;">Crushing ☐</td> <td style="border: none;">Countersink ☐</td> <td style="border: none;">Off-set ☐</td> <td style="border: none;">☒ Drawing</td> </tr> <tr> <td style="border: none;">Heat Treat ☐</td> <td style="border: none;">Cut Too Short ☐</td> <td style="border: none;">Mislabeled ☐</td> <td style="border: none;">Finish ☐</td> </tr> <tr> <td style="border: none;">Wave/Twist in Tube ☐</td> <td style="border: none;">Instructions Incomplete/Unclear ☐</td> <td style="border: none;">Fit/Function ☐</td> <td style="border: none;">Misread ☐</td> </tr> <tr> <td style="border: none;">Marks/Chatter ☐</td> <td style="border: none;">Drill Holes ☐</td> <td style="border: none;">Misaligned/off center ☐</td> <td style="border: none;">Turning Sequence ☐</td> </tr> </table>			Pressure/Forced ☐	Temperature/Cure ☐	Power Loss/Surge ☐	Positioned Wrong ☐	Bending ☐	Set-up ☐	Folio/Program ☐	Outside Dimensions ☐	Centre Not Concentric ☐	BOM/Route ☐	Grain ☐	Over/Under tolerance ☐	Cracks ☐	Broken/Damage/Defect ☐	Weld ☐	Part Incorrect ☐	Crimp/Kink/Ripple/Wave ☐	Inspection Incomplete/Unqualified ☐	Wrong Stock Pulled ☐	Part Lost/Missing ☐	Cuffs ☐	Contamination ☐	Out of Sequence ☐	Part Moved ☐	Crushing ☐	Countersink ☐	Off-set ☐	☒ Drawing	Heat Treat ☐	Cut Too Short ☐	Mislabeled ☐	Finish ☐	Wave/Twist in Tube ☐	Instructions Incomplete/Unclear ☐	Fit/Function ☐	Misread ☐	Marks/Chatter ☐	Drill Holes ☐	Misaligned/off center ☐	Turning Sequence ☐
Pressure/Forced ☐	Temperature/Cure ☐	Power Loss/Surge ☐	Positioned Wrong ☐	
Bending ☐	Set-up ☐	Folio/Program ☐	Outside Dimensions ☐	
Centre Not Concentric ☐	BOM/Route ☐	Grain ☐	Over/Under tolerance ☐	
Cracks ☐	Broken/Damage/Defect ☐	Weld ☐	Part Incorrect ☐	
Crimp/Kink/Ripple/Wave ☐	Inspection Incomplete/Unqualified ☐	Wrong Stock Pulled ☐	Part Lost/Missing ☐	
Cuffs ☐	Contamination ☐	Out of Sequence ☐	Part Moved ☐	
Crushing ☐	Countersink ☐	Off-set ☐	☒ Drawing	
Heat Treat ☐	Cut Too Short ☐	Mislabeled ☐	Finish ☐	
Wave/Twist in Tube ☐	Instructions Incomplete/Unclear ☐	Fit/Function ☐	Misread ☐	
Marks/Chatter ☐	Drill Holes ☐	Misaligned/off center ☐	Turning Sequence ☐	
		OTHER :	

Wednesday, September 02, 2015 2:45:15 PM

136713

Page 2

N900040100

Setup Start *NS1*

Stop *NS2*

Start Date: 9/1/2015 **Start Qty:** 50.00 ***50***

Cust Item ID:

Required Date: 9/1/2015 **Req'd Qty:** 50.00 ***50***

Customer:

Reference:

Run Start *NR1*

Approvals: **Process Plan:** _____ **Date:** _____ **Tooling:** _____ **Date:** _____

Stop *NR2*

QC: _____ Date: _____ SPC (Y/N): _____ Date: _____

**Insp.
Stamp**

0.00

130

OC

Memo

0.02

Quality Control

0.00

140

Brake NC

NC BRAKE

Memo

0.04

Brake NC

DAS

30

9-89

OCT 05 2015

0.00

150

QC

Memo

0.02

Quality Control

DQA: _____ Date: _____

WORK ORDER NON-CONFORMANCE / UPDATE



QA Closed: _____ Date: _____

Work Order update only ☐

Work Order: _____ Part No. _____ NCR No. _____		DISPOSITION Rework ☐ Scrap ☐ Use-as-is ☐ Suspected Unapproved ☐		AGAINST DEPARTMENT/PROCESS <table style="width:100%; border: none;"> <tr> <td style="border: none;">Skid-tube ☐</td> <td style="border: none;">Cross tube ☐</td> <td style="border: none;">Water Jet ☐</td> <td style="border: none;">Engineering ☐</td> </tr> <tr> <td style="border: none;">Machining ☐</td> <td style="border: none;">Small Fab ☐</td> <td style="border: none;">Prod. Eng. Coord. ☐</td> <td style="border: none;">Quality ☐</td> </tr> <tr> <td style="border: none;">Thermoforming ☐</td> <td style="border: none;">Finishing ☐</td> <td style="border: none;">Rec/Store/Packaging ☐</td> <td style="border: none;">Other ☐</td> </tr> <tr> <td style="border: none;">Large Fab ☐</td> <td style="border: none;">Composite ☐</td> <td style="border: none;">Supplier ☐</td> <td></td> </tr> </table>						Skid-tube ☐	Cross tube ☐	Water Jet ☐	Engineering ☐	Machining ☐	Small Fab ☐	Prod. Eng. Coord. ☐	Quality ☐	Thermoforming ☐	Finishing ☐	Rec/Store/Packaging ☐	Other ☐	Large Fab ☐	Composite ☐	Supplier ☐	
Skid-tube ☐	Cross tube ☐	Water Jet ☐	Engineering ☐																						
Machining ☐	Small Fab ☐	Prod. Eng. Coord. ☐	Quality ☐																						
Thermoforming ☐	Finishing ☐	Rec/Store/Packaging ☐	Other ☐																						
Large Fab ☐	Composite ☐	Supplier ☐																							
Date :		Step #:		QTY Effective :			MRB (QS1042) Approval																		
Description Work Order Deviation				Disposition				Completed By																	
								Lead hand / Supervisor Approval Verification																	
								QC / QA Coordinator Approval																	
Root Cause		FAULT CATEGORY																							
Environment ☐ Design ☐ Doc/Data ☐ Equip/Tooling ☐ Handling/Pre ☐ Material ☐ Internal Transport ☐ Tribal Knowledge ☐ LOA ☐ Substation ☐ Past Expiry Date ☐ Misidentified ☐	No Re-verification ☐ Operator ☐ Offset/Setup ☐ Supplier ☐ Training ☐ Use for Testing ☐ Poor Information ☐ Rushing ☐ Product Improvement ☐ Process Improvement ☐ Manufacturing Process ☐ Past Due ☐	Pressure/Forced ☐ Bending ☐ Centre Not Concentric ☐ Cracks ☐ Crimp/Kink/Ripple/Wave ☐ Cuffs ☐ Crushing ☐ Heat Treat ☐ Wave/Twist in Tube ☐ Marks/Chatter ☐	Temperature/Cure ☐ Set-up ☐ BOM/Route ☐ Broken/Damage/Defect ☐ Inspection Incomplete/Unqualified ☐ Contamination ☐ Countersink ☐ Cut Too Short ☐ Instructions Incomplete/Unclear ☐ Drill Holes ☐	Power Loss/Surge ☐ Folio/Program ☐ Grain ☐ Weld ☐ Wrong Stock Pulled ☐ Out of Sequence ☐ Off-set ☐ Misabeled ☐ Fit/Function ☐ Misaligned/off center ☐	Positioned Wrong ☐ Outside Dimensions ☐ Over/Under tolerance ☐ Part Incorrect ☐ Part Lost/Missing ☐ Part Moved ☐ Drawing ☐ Finish ☐ Misread ☐ Turning Sequence ☐	OTHER : _____																			

Wednesday, September 02, 2015 2:45:15 PM

Page 3

Quality Control

50 Q 15-10-8

50 _____

DAS
38
9-89
OCT 13 2015

(50) _____ JAS
 38
 9-89
 OCT 13 2015

DQA: _____ Date: _____



WORK ORDER NON-CONFORMANCE / UPDATE

QA Closed: _____ Date: _____

Work Order update only ☐

Work Order: _____ Part No. _____ NCR No. _____	DISPOSITION Rework ☐ Scrap ☐ Use-as-is ☐ Suspected Unapproved ☐	AGAINST DEPARTMENT/PROCESS Skid-tube ☐ Machining ☐ Thermoforming ☐ Large Fab ☐ Cross tube ☐ Small Fab ☐ Finishing ☐ Composite ☐ Water Jet ☐ Prod. Eng. Coord. ☐ Rec/Store/Packaging ☐ Supplier ☐ Engineering ☐ Quality ☐ Other ☐			
Date :	Step #:	QTY Effective :		MRB (QSI042) Approval	
Description Work Order Deviation		Disposition		Completed By	
				Lead hand / Supervisor Approval Verification	
				QC / QA Coordinator Approval	
Root Cause Environment ☐ Design ☐ Doc/Data ☐ Equip/Tooling ☐ Handling/Pre ☐ Material ☐ Internal Transport ☐ Tribal Knowledge ☐ LOA ☐ Substation ☐ Past Expiry Date ☐ Misidentified ☐ No Re-verification ☐ Operator ☐ Offset/Setup ☐ Supplier ☐ Training ☐ Use for Testing ☐ Poor Information ☐ Rushing ☐ Product Improvement ☐ Process Improvement ☐ Manufacturing Process ☐ Past Due ☐		FAULT CATEGORY Pressure/Forced ☐ Bending ☐ Centre Not Concentric ☐ Cracks ☐ Crimp/Kink/Ripple/Wave ☐ Cuffs ☐ Crushing ☐ Heat Treat ☐ Wave/Twist in Tube ☐ Marks/Chatter ☐ Temperature/Cure ☐ Set-up ☐ BOM/Route ☐ Broken/Damage/Defect ☐ Inspection Incomplete/Unqualified ☐ Contamination ☐ Countersink ☐ Cut Too Short ☐ Instructions Incomplete/Unclear ☐ Drill Holes ☐ Power Loss/Surge ☐ Folio/Program ☐ Grain ☐ Weld ☐ Wrong Stock Pulled ☐ Out of Sequence ☐ Off-set ☐ Misabeled ☐ Fit/Function ☐ Misaligned/off center ☐ Positioned Wrong ☐ Outside Dimensions ☐ Over/Under tolerance ☐ Part Incorrect ☐ Part Lost/Missing ☐ Part Moved ☐ Drawing ☐ Finish ☐ Misread ☐ Turning Sequence ☐			
OTHER : ☐					

Work Order ID 136713

Wednesday, September 02, 2015 2:45:15 PM

136713

Page 4

Item ID: D3537-1 Accept ***N900040100*** Setup Start ***NS1***
 Revision ID: Stop ***NS2***
 Item Name: Wearpad
 Start Date: 9/1/2015 Start Qty: 50.00 ***50*** Cust Item ID:
 Required Date: 9/1/2015 Req'd Qty: 50.00 ***50*** Customer:
 Reference:

Approvals: Process Plan: _____ Date: _____ Tooling: _____ Date: _____ Run Start ***NR1***
 QC: _____ Date: _____ SPC (Y/N): _____ Date: _____ Stop ***NR2***

Sequence ID/ Work Center ID	Operation Description	Set Up/ Run Hours	Tool ID	Tool #	Plan Code	Accept Qty	Reject Qty	Reject Number	Insp. Stamp
210	Identify as per dwg & Stock Location: <u>PREL17</u>	0.00							
210									DAS 38 9-89
Packaging	Memo	0.01							
Packaging	LOCATION : FP001								
220	QC21- Final Inspection - Work Order Release	0.00							
220									
QC	Memo	0.08							
Quality Control									

POSITIVE RECALL

EFFECTIVE 9/1/2015 AUTH HLJ

RELEASED PD DATE 15-12-15

Rev E
ECN 15-651

MLJ

15-12-15

MLJ 15-11-13

OCT 13 2015

DQA: _____ Date: _____



WORK ORDER NON-CONFORMANCE / UPDATE

QA Closed: _____ Date: _____

Work Order update only ☐

Work Order: _____ Part No. _____ NCR No. _____	DISPOSITION Rework ☐ Scrap ☐ Use-as-is ☐ Suspected Unapproved ☐	AGAINST DEPARTMENT/PROCESS Skid-tube ☐ Machining ☐ Thermoforming ☐ Large Fab ☐ Cross tube ☐ Small Fab ☐ Finishing ☐ Composite ☐ Water Jet ☐ Prod. Eng. Coord. ☐ Rec/Store/Packaging ☐ Supplier ☐ Engineering ☐ Quality ☐ Other ☐			
Date :	Step #:	QTY Effective :		MRB (QSI042) Approval	
Description Work Order Deviation		Disposition		Completed By	
				Lead hand / Supervisor Approval Verification	
				QC / QA Coordinator Approval	
Root Cause		FAULT CATEGORY			
Environment ☐	No Re-verification ☐	Pressure/Forced ☐	Temperature/Cure ☐	Power Loss/Surge ☐	Positioned Wrong ☐
Design ☐	Operator ☐	Bending ☐	Set-up ☐	Folio/Program ☐	Outside Dimensions ☐
Doc/Data ☐	Offset/Setup ☐	Centre Not Concentric ☐	BOM/Route ☐	Grain ☐	Over/Under tolerance ☐
Equip/Tooling ☐	Supplier ☐	Cracks ☐	Broken/Damage/Defect ☐	Weld ☐	Part Incorrect ☐
Handling/Pre ☐	Training ☐	Crimp/Kink/Ripple/Wave ☐	Inspection Incomplete/Unqualified ☐	Wrong Stock Pulled ☐	Part Lost/Missing ☐
Material ☐	Use for Testing ☐	Cuffs ☐	Contamination ☐	Out of Sequence ☐	Part Moved ☐
Internal Transport ☐	Poor Information ☐	Crushing ☐	Countersink ☐	Off-set ☐	Drawing ☐
Tribal Knowledge ☐	Rushing ☐	Heat Treat ☐	Cut Too Short ☐	Mislabeled ☐	Finish ☐
LOA ☐	Product Improvement ☐	Wave/Twist in Tube ☐	Instructions Incomplete/Unclear ☐	Fit/Function ☐	Misread ☐
Substation ☐	Process Improvement ☐	Marks/Chatter ☐	Drill Holes ☐	Misaligned/off center ☐	Turning Sequence ☐
Past Expiry Date ☐	Manufacturing Process ☐				
Misidentified ☐	Past Due ☐	OTHER :			

Picklist Print

Page 1

Wednesday, September 02, 2015 2:45:15 PM

Work Order ID: 136713

136713

Parent Item: D3537-1

D3537-1

Parent Item Name: Wearpad

Start Date: 9/1/2015

Required Date: 9/1/2015

Start Qty: 50.00

Required Qty: 50.00

Comments: IPP Rev:A New Issue 07-02-14 JLM

Component Item ID/ Item Name	Replacement Item ID	Mfg/ Purch	Bin Item	Primary Location	Last Location	Route Seq ID	Unit of Measure	Qty on Hand	Qty per Kit	Total Qty	Qty Issued	Date Issued	Status
M304S16GA		Purchased	No			100	sf	282.3900	0.106	5.578947			

M304S16GA

06/15/09/30

304/316 Sheet .063

Location

Loc Qty

Loc Code

MAT019

282.39

m131384

35.2

m131503

21.19

m132797

64

m132835

162

6

DQA: _____ Date: _____




WORK ORDER NON-CONFORMANCE / UPDATE

QA Closed: _____ Date: _____



Work Order update only ☐

Work Order: _____ Part No. _____ NCR No. _____		DISPOSITION Rework ☐ Scrap ☐ Use-as-is ☐ Suspected Unapproved ☐		AGAINST DEPARTMENT/PROCESS <table style="width: 100%; border: none;"> <tr> <td style="border: none;">Skid-tube ☐</td> <td style="border: none;">Cross tube ☐</td> <td style="border: none;">Water Jet ☐</td> <td style="border: none;">Engineering ☐</td> </tr> <tr> <td style="border: none;">Machining ☐</td> <td style="border: none;">Small Fab ☐</td> <td style="border: none;">Prod. Eng. Coord. ☐</td> <td style="border: none;">Quality ☐</td> </tr> <tr> <td style="border: none;">Thermoforming ☐</td> <td style="border: none;">Finishing ☐</td> <td style="border: none;">Rec/Store/Packaging ☐</td> <td style="border: none;">Other ☐</td> </tr> <tr> <td style="border: none;">Large Fab ☐</td> <td style="border: none;">Composite ☐</td> <td style="border: none;">Supplier ☐</td> <td></td> </tr> </table>						Skid-tube ☐	Cross tube ☐	Water Jet ☐	Engineering ☐	Machining ☐	Small Fab ☐	Prod. Eng. Coord. ☐	Quality ☐	Thermoforming ☐	Finishing ☐	Rec/Store/Packaging ☐	Other ☐	Large Fab ☐	Composite ☐	Supplier ☐	
Skid-tube ☐	Cross tube ☐	Water Jet ☐	Engineering ☐																						
Machining ☐	Small Fab ☐	Prod. Eng. Coord. ☐	Quality ☐																						
Thermoforming ☐	Finishing ☐	Rec/Store/Packaging ☐	Other ☐																						
Large Fab ☐	Composite ☐	Supplier ☐																							
Date :		Step #:		QTY Effective :			MRB (QSI042) Approval																		
Description Work Order Deviation				Disposition			Completed By																		
							Lead hand / Supervisor Approval Verification																		
							QC / QA Coordinator Approval																		
Root Cause		FAULT CATEGORY																							
Environment ☐ Design ☐ Doc/Data ☐ Equip/Tooling ☐ Handling/Pre ☐ Material ☐ Internal Transport ☐ Tribal Knowledge ☐ LOA ☐ Substation ☐ Past Expiry Date ☐ Misidentified ☐	No Re-verification ☐ Operator ☐ Offset/Setup ☐ Supplier ☐ Training ☐ Use for Testing ☐ Poor Information ☐ Rushing ☐ Product Improvement ☐ Process Improvement ☐ Manufacturing Process ☐ Past Due ☐	Pressure/Forced ☐ Bending ☐ Centre Not Concentric ☐ Cracks ☐ Crimp/Kink/Ripple/Wave ☐ Cuffs ☐ Crushing ☐ Heat Treat ☐ Wave/Twist in Tube ☐ Marks/Chatter ☐	Temperature/Cure ☐ Set-up ☐ BOM/Route ☐ Broken/Damage/Defect ☐ Inspection Incomplete/Unqualified ☐ Contamination ☐ Countersink ☐ Cut Too Short ☐ Instructions Incomplete/Unclear ☐ Drill Holes ☐	Power Loss/Surge ☐ Folio/Program ☐ Grain ☐ Weld ☐ Wrong Stock Pulled ☐ Out of Sequence ☐ Off-set ☐ Mislabelled ☐ Fit/Function ☐ Misaligned/off center ☐	Positioned Wrong ☐ Outside Dimensions ☐ Over/Under tolerance ☐ Part Incorrect ☐ Part Lost/Missing ☐ Part Moved ☐ Drawing ☐ Finish ☐ Misread ☐ Turning Sequence ☐	OTHER : ☐																			

PRELIMINARY ISSUE

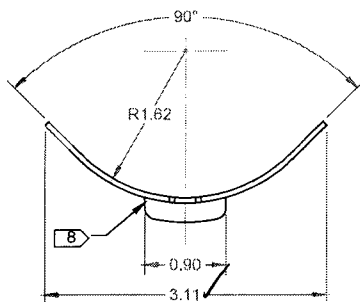

D3537-1 WEARPAD

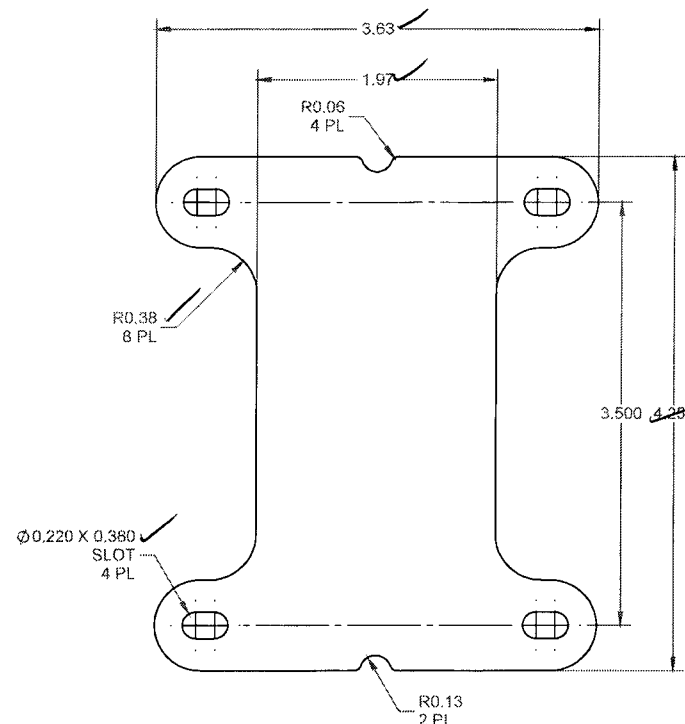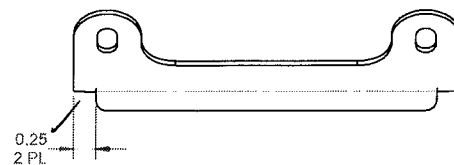

**D3537-1F WEARPAD
(FLAT PATTERN)**


NOTES:

- 1) MATERIAL -1: MAKE FROM -1F
-1F: AISI 304/316 SS SHEET ANNEALED, 16 GAUGE (0.063) PER MIL-S-5059 OR AMS 5513 (304)
OR AMS 5524 (316) OR ASTM A240 OR ASME SA240 PER DART SPEC M304S16GA
- 2) FINISH: NONE
- 3) TOLERANCES: PER DART QSI 018 UNLESS OTHERWISE NOTED
- 4) UNITS: INCHES UNLESS OTHERWISE NOTED
- 5) BREAK SHARP EDGES: 0.005 TO 0.010 MAX
- 6) IDENTIFICATION: IDENTIFY PER QSI 044 6.1
- 7) WEIGHT: 0.42 lbs
- 8) BUILDUP HARD SURFACING 0.17 - 0.20 THICK USING 8259 ROD PER QSI 004 SECTION 4.5 (AUTOMATED WELDING) OR
BUILDUP HARD SURFACING 0.19 - 0.25 THICK USING 2059B ROD PER QSI 004 SECTION 4.1 (MANUAL WELDING)




PRELIMINARY ISSUE



E	-5 DELETED PART IS OBSOLETE. RE-FORMAT. NOTE 8 RE-WRITTEN FOR ROBOTIC WELDING.	AJS	15.09.28
D	RE-FORMAT DRAWING, ADD -9/-11 WEARPADS	DB	14.10.16
C	WIDEN TAB TO 0.380, WEL PATTERN	CB	07.04.13
B	ADD AMS5510 AND AMS 5524	CB	07.03.20
A	NEW ISSUE	CB	06.11.06
REV.	DESCRIPTION	BY	DATE
DESIGN	CB	DART AEROSPACE USA, INC. KENT, WA	
DRAWN	AJS		
CHECKED	CP	DRAWING NO.	REV. XX
MFG. APPR.	DD	D3537	SHEET 1 OF 5
APPROVED		TITLE	SCALE
DE APPR.		WEARPAD	NTS
DATE	15.09.28	COPYRIGHT © 2006 BY DART AEROSPACE USA, INC. THIS DOCUMENT IS PRIVATE AND CONFIDENTIAL AND IS SUPPLIED ON THE EXPRESS CONDITION THAT IT IS NOT TO BE USED FOR ANY PURPOSE OR COPIED OR COMMUNICATED TO ANY OTHER PERSON WITHOUT WRITTEN PERMISSION FROM DART AEROSPACE USA, INC.	

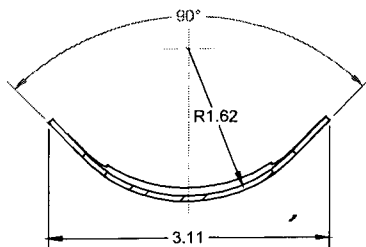


SECTION A-A

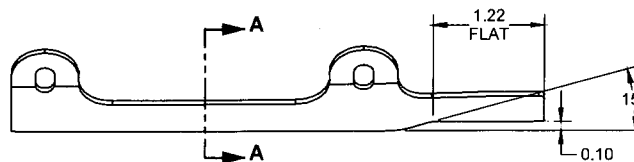

D3537-3 WEARPAD
(BENDING DETAIL)
(MAKE FROM D3537-3F)

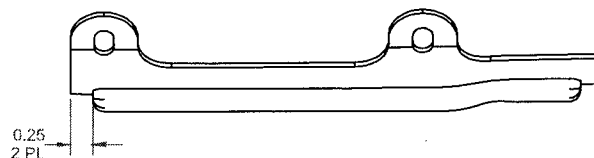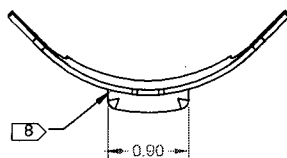

D3537-3 WEARPAD
(WELDMENT)

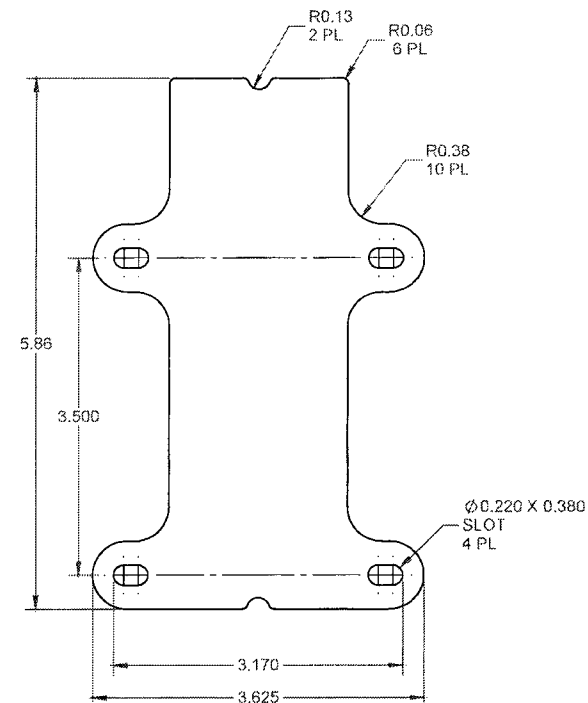

D3537-3F WEARPAD
(FLAT PATTERN)



NOTES:

- 1) MATERIAL: -3: MAKE FROM -3F
-3F: AISI 304/316 SS SHEET ANNEALED, 16 GAUGE (0.063) PER MIL-S-5059 OR AMS 5513 (304) OR AMS 5524 (316) OR ASTM A240 OR ASME SA240 PER DART SPEC M304S16GA
- 2) FINISH: NONE
- 3) TOLERANCES: PER DART QSI 018 UNLESS OTHERWISE NOTED
- 4) UNITS: INCHES UNLESS OTHERWISE NOTED
- 5) BREAK SHARP EDGES: 0.005 TO 0.010 MAX
- 6) IDENTIFICATION: IDENTIFY PER QSI 044 6.1
- 7) WEIGHT: 0.50 lbs
- 8) BUILDUP HARD SURFACING 0.17 - 0.20 THICK USING 8259 ROD PER QSI 004 SECTION 4.5 (AUTOMATED WELDING) OR BUILDUP HARD SURFACING 0.19 - 0.25 THICK USING 2059B ROD PER QSI 004 SECTION 4.1 (MANUAL WELDING)



PRELIMINARY ISSUE

DESIGN	CB	DART AEROSPACE USA, INC.	
DRAWN	AJS	KENT, WA	
CHECKED	CP	DRAWING NO.	REV. XX
MFG. APPR.	DD	D3537	SHEET 2 OF 5
APPROVED		TITLE	SCALE
DE APPR.		WEARPAD	NTS
DATE	15.09.28	COPYRIGHT © 2006 BY DART AEROSPACE USA, INC. THIS DOCUMENT IS PRIVATE AND CONFIDENTIAL AND IS SUPPLIED ON THE EXPRESS CONDITION THAT IT IS NOT TO BE USED FOR ANY PURPOSE OR COPIED OR COMMUNICATED TO ANY OTHER PERSON WITHOUT WRITTEN PERMISSION FROM DART AEROSPACE USA, INC.	

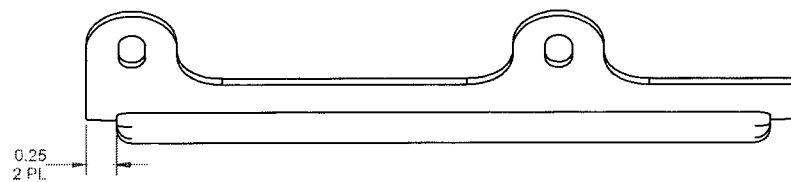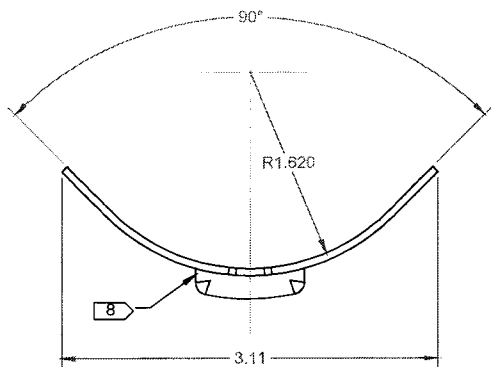

D3537-7 WEARPAD
(MAKE FROM D3537-3F)



NOTES:

- 1) MATERIAL: MAKE FROM -3F
- 2) FINISH: NONE
- 3) TOLERANCES: PER DART QSI 018 UNLESS OTHERWISE NOTED
- 4) UNITS: INCHES UNLESS OTHERWISE NOTED
- 5) BREAK SHARP EDGES: 0.005 TO 0.010 MAX
- 6) IDENTIFICATION: IDENTIFY PER QSI 044 6.1
- 7) WEIGHT: 0.50 lbs
- 8) BUILDUP HARD SURFACING 0.17 - 0.20 THICK USING 8259 ROD PER QSI 004 SECTION 4.5 (AUTOMATED WELDING) OR BUILDUP HARD SURFACING 0.19 - 0.25 THICK USING 2059B ROD PER QSI 004 SECTION 4.1 (MANUAL WELDING)



PRELIMINARY ISSUE

DESIGN	CB	DART AEROSPACE USA, INC.	
DRAWN	AJS	KENT, WA	
CHECKED	CP	DRAWING NO.	REV. A2
MFG. APPR.	DD	D3537	SHEET 3 OF 5
APPROVED		TITLE	SCALE
DE APPR.		WEARPAD	NTS
DATE	15.09.28	COPYRIGHT © 2006 BY DART AEROSPACE USA, INC. THIS DOCUMENT IS PRIVATE AND CONFIDENTIAL AND IS SUPPLIED ON THE EXPRESS CONDITION THAT IT IS NOT TO BE USED FOR ANY PURPOSE OR COPIED OR REPRODUCED IN ANY MANNER WITHOUT WRITTEN PERMISSION FROM DART AEROSPACE USA, INC.	

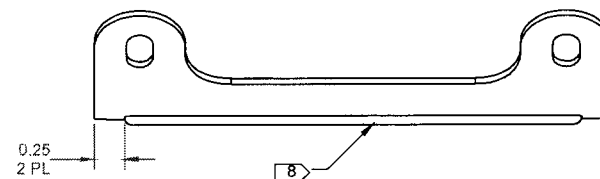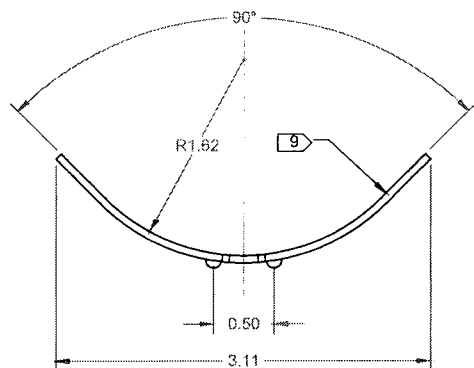

D3537-9 WEARPAD
(MAKE FROM -1F)


NOTES:

- 1) MATERIAL : MAKE FROM -1F
- 2) FINISH: NONE
- 3) TOLERANCES: PER DART QSI 018 UNLESS OTHERWISE NOTED
- 4) UNITS: INCHES UNLESS OTHERWISE NOTED
- 5) BREAK SHARP EDGES: 0.005 TO 0.010 MAX
- 6) IDENTIFICATION: IDENTIFY PER QSI 044 6.1
- 7) WEIGHT: 0.19 lbs
- 8) APPLY HARD SURFACING WELD BEAD 0.06 - 0.13 THICK USING 8259 ROD PER QSI 004 SECTION 4.5 (AUTOMATED WELDING) OR APPLY HARD SURFACING WELD BEAD 0.06 - 0.13 THICK USING 2059B ROD PER QSI 004 SECTION 4.1 (MANUAL WELDING)
- 9) COAT ENTIRE TOP (CONCAVE) SURFACE WITH TEXTURED COATING, 0.02-0.04 THICK, PER DART QSI 005 4.9




PRELIMINARY ISSUE



DESIGN	CB	DART AEROSPACE USA, INC.	
DRAWN	AJS	KENT, WA	
CHECKED	CP	DRAWING NO.	REV. A B
MFG. APPR.	DD	D3537	SHEET 4 OF 5
APPROVED		TITLE	SCALE
DE APPR.		WEARPAD	NTS
DATE	15.09.28	COPYRIGHT © 2006 BY DART AEROSPACE USA, INC. THIS DOCUMENT IS PRIVATE AND CONFIDENTIAL AND IS SUPPLIED ON THE EXPRESS CONDITION THAT IT IS NOT TO BE USED FOR ANY PURPOSE OR COPIED OR COMMUNICATED TO ANY OTHER PERSON WITHOUT WRITTEN PERMISSION FROM DART AEROSPACE USA, INC.	

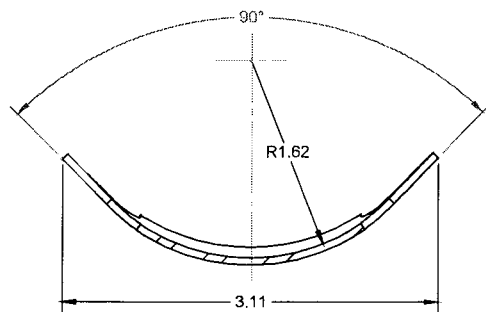

SECTION B-B

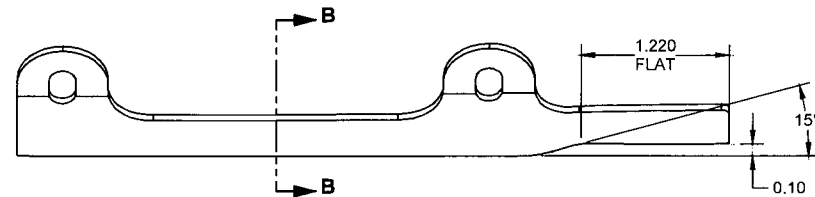

D3537-11 WEARPAD
(BENDING DETAIL)
(MAKE FROM D3537-3F)

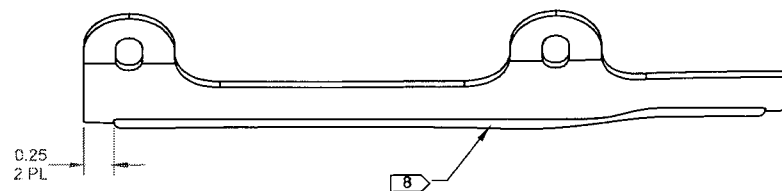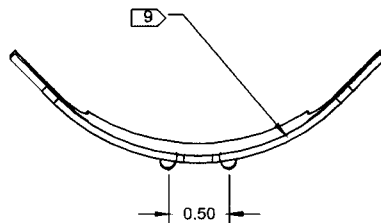

D3537-11 WEARPAD
(WELDMENT)

NOTES:

- 1) MATERIAL: MAKE FROM -3F
- 2) FINISH: NONE
- 3) TOLERANCES: PER DART QSI 018 UNLESS OTHERWISE NOTED
- 4) UNITS: INCHES UNLESS OTHERWISE NOTED
- 5) BREAK SHARP EDGES: 0.005 TO 0.010 MAX
- 6) IDENTIFICATION: IDENTIFY PER QSI 044 6.1
- 7) WEIGHT: 0.25 lbs
- 8) APPLY HARD SURFACING WELD BEAD 0.06 - 0.13 THICK USING 8259 ROD PER QSI 004 SECTION 4.5 (AUTOMATED WELDING) OR APPLY HARD SURFACING WELD BEAD 0.06 - 0.13 THICK USING 2059B ROD PER QSI 004 SECTION 4.1 (MANUAL WELDING)
- 9) COAT ENTIRE TOP (CONCAVE) SURFACE WITH TEXTURED COATING, 0.02-0.04 THICK, PER DART QSI 005 4.9



PRELIMINARY ISSUE

DESIGN	CB	DART AEROSPACE USA, INC.	
DRAWN	AJS	KENT, WA	
CHECKED	CP	DRAWING NO.	REV. XX
MFG. APPR.	DD	D3537	SHEET 5 OF 5
APPROVED		TITLE	SCALE
DE APPR		WEARPAD	NTS
DATE	15.09.28	COPYRIGHT © 2006 BY DART AEROSPACE USA, INC. THIS DOCUMENT IS PRIVATE AND CONFIDENTIAL AND IS SUPPLIED ON THE EXPRESS CONDITION THAT IT IS NOT TO BE USED FOR ANY PURPOSE OR COPIED OR COMMUNICATED TO ANY OTHER PERSON WITHOUT WRITTEN PERMISSION FROM DART AEROSPACE USA, INC.	

Purchase Order Receipt Listing

Page 1 of 2

Friday, July 24, 2015 12:53:05 PM

All amounts are calculated in domestic currency.

All Vendors PO ID PO29169 All Receipt Dates All Line Item Types
All Item ID/GL/WOs All Rec. Employees All Currencies
Grouped by Vendor ID

Purchase Order ID/ Curr Type	Line Nbr/ Insp Req	Project ID	Reference/ Description/ Cert Std	PO U/M/ Stock U/M	Required Date Required Qty	Recv Date/ Recv Emp	Recv Qty (PO U/M)	Cost Per Unit/ Recv Value	Inspected Qty/ Rejected Qty (PO U/M)	MIRB Qty/ MIRB Reject Qty	Book Amt
Vendor ID/Vendor Name VC-COP001 Thyssenkrupp Materials CA Ltd											
PO29169	1		M6061T6B0.125X2.5 F 00		7/21/2015	7/24/2015	20.0000	\$2.34	0.0000	0	\$46.70
CAD	No		6061T6 BAR .125 X F 2.50 m132835		12.0000	DCUSER		\$46.70	0.0000	0	
	2		M6061T6B2.000X01. F 250		7/21/2015	7/24/2015	12.0000	\$6.00	0.0000	0	\$72.05
	No		6061-T6 Bar 2.00 x F 1.25 m132835		12.0000	DCUSER		\$72.05	0.0000	0	
	3		M6061T6B0.750X00. F 750		7/21/2015	7/24/2015	12.0000	\$2.34	0.0000	0	\$28.02
	No		6061-T6 Bar .750 x F .750 m132835		12.0000	DCUSER		\$28.02	0.0000	0	
	4		M6061T6B0.500X05 F 000		7/21/2015	7/24/2015	12.0000	\$6.00	0.0000	0	\$72.05
	No		6061-T6 Bar .500 x F 5.00 m132835		12.0000	DCUSER		\$72.05	0.0000	0	
	5		M6061T6B0.187X04 F 000		7/21/2015	7/24/2015	12.0000	\$2.34	0.0000	0	\$28.02
	No		6061-T6 Bar .187 x F 4.00 m132835		12.0000	DCUSER		\$28.02	0.0000	0	
	6		M304S16GA 304 F		7/21/2015	7/24/2015	192.0000	\$4.00	0.0000	0	\$768.58
	No		304/316 Sheet .063 S m132835		192.0000	DCUSER		\$768.58	0.0000	0	
	7		M304B0.625X3.000 F		7/21/2015	7/24/2015	12.0000	\$20.70	0.0000	0	\$248.35
	No		304 BAR .625 X 3.00 F m132835		12.0000	DCUSER		\$248.35	0.0000	0	

B I L L O F L A D I N G
Ship From: THYSSENKRUPP MATERIALS NA
2821 LANGSTAFF ROAD
CONCORD, ONTARIO L4K 5C6
Tel: 905 669 9444 Fax: 905-738-9033

No: PEC 945295
Ship Date 20Jul15 at 12:13 From PFW
Probill
Via VIM TRANSFER
FOB CONCORD
Frt PREPAID
Route 0- 0 Manifest
Vhcle Trailer
Slp STAN IVERS (905-532-1350)
Sold To: (20115)
DART AEROSPACE

Ship To: (1)
DART AEROSPACE

B I L L O F L A D I N G

BACK ORDER

6) Our Order PEC-826392-6 Your PO # 29169
STAINLESS STEEL SHEET 304-2B
0600 Nom X 48.0000" X 96.0000"

Heat Number
BOA005-AFD

Tag No
435532

Quantity
192.00 SFT

PCS
6

MTR

Wt LBS
462

TOTAL

Tags
5

PCS
10

LBS
550

Heat Number
103621 2 1-A-1
408691-7
41743-1
BOA005-AFD
Z00136096

*** Chemical Analysis ***

SP10-07-24

MILL TEST REPORTS, PACKING SLIPS ARE TO SENT
WITH MATERIAL AND FAXED TO THE CUSTOMER PRIOR
TO SHIPPING.

ATTN: CHANTAL/LINDA

** ALL PACKING SLIPS MUST HAVE THE HEAT NUMBER **
** REFERENCED ON IT **

TOTAL 2 BDLS 1 SKID GW 652 LBS

ITEM# 1 - 1 BDL
ITEM# 2 TO 4 - 1 BDL
ITEM# 5 - B/O
ITEM# 6 - 1 SKID

*CUSTOMER PICK-UP HRS AT THYSSENKRUPP MATERIALS NA

Page: 2Continued

TOUTES ERREURS ET/OU MARCHANDISES MANQUANTES DOIVENT ÊTRE
RAPPORTÉES IMMÉDIATEMENT
ERRORS OR SHORTAGE MUST BE REPORTED IMMEDIATELY
RETOUR DE MARCHANDISES AVEC NOTRE NUMÉRO D'APPROBATION SEULEMENT
MERCHANDISE MAY NOT BE RETURNED WITHOUT OUR APPROVAL NUMBER

REÇU EN BONNE CONDITIONS / RECEIVED IN GOOD CONDITION

DATE

THYSSENKRUPP MATERIALS NA

DART AEROSPACE

STAINLESS STEEL SHEET 304-2B
0600 Nom X 48.0000" X 96.0000"
PART-NO.

PO/Rel 29169

We certify that this is a true copy of the report
furnished by the producer of the metal, or data
resulting from tests made in approved labs.

Certificate of Mill Test Results

BL PEC-945295-006

17Jul15

Pg 1/1

Signed by: _____



連錫鋼鐵股份有限公司
YUEN CHANG STAINLESS STEEL CO., LTD.

檢驗證明書

MILL TEST CERTIFICATE(S)

列印日期 ISSUE DATE: 2015/03/24

DAS
14
9-89

高雄市前金區中正西路235號13F
13F, No. 235 Jungjeng 4th Road, Chianjin
Chi, Kaohsiung, Taiwan
TEL: 886-7-9695858 FAX: 886-7-9685768
http://www.yuenchang.com.tw

客戶名稱 Customer	Thyssenkrupp Steel Services A Division Of Thyssenkrupp Materials Na Inc 22355 West Eleven Mile Road Southfield Mi 48033 USA																
商品描述 Desc. Of Goods	Description Of Goods And/Or Services : Prime, Cold Rolled Stainless Steel Sheets, Slitted Edge, As Per ASTM A240/A480: Thyssenkrupp Materials NA PO PEC-264559																
項目 Item	鋼捲編號 Coil No.	爐號 Heat Number(S)	鋼種 Steel Grade	表面 Finish	產品尺寸 Thickness x Width x Length	淨重 Net Weight (KGS)											
AF009	CAAL0268-14	DNF010-ADG	304	2B	26GA x 48 x 96	1,727											
AF010	CCWR0003-18	AOA004-AAB	304	2B	20GA x 48 x 96	1,102											
AF011	CCWR0003-19	AOA004-AAB	304	2B	20GA x 48 x 96	1,104											
AF003	CATF0015-20	BOA005-AFD	304	2B	16GA x 48 x 96	1,735											
AF001	CATF0015-18	BOA005-AFD	304	2B	16GA x 48 x 120	1,086											
AF002	CATF0015-19	BOA005-AFD	304	2B	16GA x 48 x 120	1,087											
AF008	CCYL0003-54	AOA002-AAD	304	2B	14GA x 48 x 144	901											
AF006	CARS0019-13	BOB006-ABD	304	2B	12GA x 48 x 96	1,073											
化學成分 Chemical Analysis (%)																	
Item	C	Si	Mn	P	S	Cr	Ni	N	Cu	Mo	Others	T.S N/MM2	Y.S(0.2%) N/MM2	Elong (%)	HB	HRB	HV
AF009	0.045	0.480	1.158	0.037	0.0022	18.055	8.010	0.042	0.043			755	300	58.0		83.5	
AF010	0.023	0.300	1.380	0.029	0.0112	18.250	8.040	0.071	0.310	0.110		651	294	57.0			160.0
AF011	0.023	0.300	1.380	0.029	0.0112	18.250	8.040	0.071	0.310	0.110		651	294	57.0			160.0
AF003	0.050	0.430	1.110	0.039	0.0010	18.300	8.100	0.040	0.056	0.098		686	281	56.0		83.0	
AF001	0.050	0.430	1.110	0.039	0.0010	18.300	8.100	0.040	0.056	0.098		686	281	56.0		83.0	
AF002	0.050	0.430	1.110	0.039	0.0010	18.300	8.100	0.040	0.056	0.098		686	281	56.0		83.0	
AF008	0.042	0.510	0.980	0.033	0.0020	18.190	8.040	0.058				644	280	54.9		83.5	
AF006	0.040	0.440	1.070	0.030	0.0020	18.200	8.000	0.040	0.188	0.040		650	272	56.0		83.5	
機械性質 Mechanical Properties																	
茲證明本廠所列產品，均係材料規格製造及試驗，並符合規格之要求。 We hereby certify that the products described herein have been manufactured and tested with satisfactory results in accordance with the requirement of the above material specification. 本產品無輻射污染，並且不含汞。The material described above is free from radiation contamination and mercury. 本證明書符合EN10204/Type 3.1規格。Inspection certificate in accordance with EN10204/Type 3.1. 本廠所列產品均符合ASTM A240規範要求。All the above products conform to the requirements specified in ASTM A240. We Hereby Certifying The Material To ASTM A240/ A480 As Per EN 10204/ 3.1																	
For and on behalf of YUEN CHANG STAINLESS STEEL CO., LTD. Authorized Signature																QC Manager David Wang	



Dart Aerospace Ltd.
1270 Aberdeen Street
Hawkesbury, ON K6A 1K7
Tel: 613 632 9577
Fax: 613 632 1053

PURCHASE ORDER

Purchase Order ID PO29169

Purchase Order Date 7/16/2015

PO Print Date 7/16/2015

Page Number 2 of 4

Order From : VC-COP001
THYSSENKRUPP MATERIALS CA LTD
O/A VPK METAL- C/O T27540/PO BOX 4275,POSTAL"A"
TORONTO, ON M5W 5V8
CA

Ship To : DART AEROSPACE LTD
1270 ABERDEEN
HAWKESBURY, ON K6A 1K7
CANADA

Contact Name
Vendor Phone 905 669 9444


Ship To Contact
Ship To Phone
Ship Via: VENDOR'S TRUCK
Ship Acct:

Buyer Linda Lacelle
Customer POID
Customer Tax # 10127-2607
Terms Net 30
Currency CAD
FOB FCA - (Free Carrier)

					Line Total:	\$35.00
4	M6061T6B0.500X05.000	6061-T6 Bar .500 x 5.00	7/21/2015 Yes 7/21/2015	12.00 f	\$7.50	\$90.00
as above					Line Total:	\$90.00
5	M6061T6B0.187X04.000	6061-T6 Bar .187 x 4.00	7/21/2015 Yes 7/21/2015	12.00 f	\$2.92	\$35.00
as above					Line Total:	\$35.00
6	M304S16GA	304/316 Sheet .063	7/21/2015 Yes 7/21/2015	192.00 sf	\$5.00	\$960.00
MATERIAL: AISI 304/316 SS SHEET ANNEALED AS PER MIL-S-5059/AMS 5513 (304)/AMS 5524 (316)/ASTM A240/ASME SA240					Line Total:	\$960.00

Note:


7/16/2015

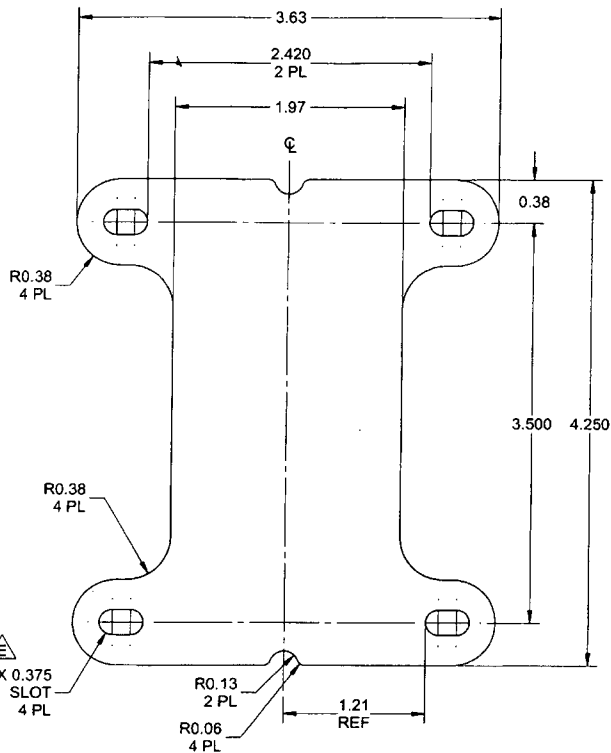


D3537-1F WEARPAD
(FLAT PATTERN)

NOTES:

- 1) MATERIAL: AISI 304/316 STAINLESS STEEL 16 GAUGE 0.063 THICK
PER MIL-S-5059 OR AMS 5513 OR 5524 OR ASTM A240 OR ASME SA240
REF DART SPEC. M304S16GA
- 2) FINISH: NONE
- 3) TOLERANCES: PER DART QSI 018 UNLESS OTHERWISE NOTED
- 4) UNITS: INCHES UNLESS OTHERWISE NOTED
- 5) BREAK SHARP EDGES: 0.005 TO 0.010 MAX
- 6) IDENTIFICATION: IDENTIFY PER QSI 044 6.1
- 7) WEIGHT: 0.42 lbs
- 8) BUILDUP HARD SURFACING 0.17 - 0.20 THICK USING 8259 ROD PER QSI 004 SECTION 4.5 (AUTOMATED WELDING) OR
BUILDUP HARD SURFACING 0.19 - 0.25 THICK USING 2059B ROD PER QSI 004 SECTION 4.1 (MANUAL WELDING)

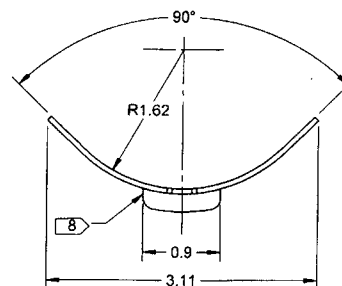


D3537-1 WEARPAD
MAKE FROM D3537-1F

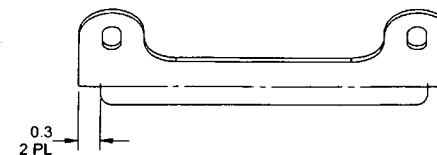


RELEASED
2015-12-07
EUN 15-651

REV.	DESCRIPTION	BY	DATE																										
E	-5 DELETED PART IS OBSOLETE. RE-FORMAT. NOTE 8 RE-WRITTEN FOR ROBOTIC WELDING. SHEETS 1 & 2 SLOT DIMENSION UPDATED.	AJS	15.09.28																										
D	RE-FORMAT DRAWING. ADD -9/-11 WEARPADS	DB	14.10.16																										
C	WIDEN TAB TO 0.380. WEL PATTERN	CB	07.04.13																										
B	ADD AMS5510 AND AMS 5524	CB	07.03.20																										
A	NEW ISSUE	CB	06.11.06																										
<table border="1"> <tr> <td>DESIGN</td><td>CB</td><td colspan="2" rowspan="2">DART AEROSPACE USA, INC. EUGENE, OR</td></tr> <tr> <td>DRAWN</td><td>AJS</td></tr> <tr> <td>CHECKED</td><td>AP</td><td>DRAWING NO.</td><td>REV. E</td></tr> <tr> <td>MFG. APPR.</td><td>JLM</td><td>D3537</td><td>SHEET 1 OF 5</td></tr> <tr> <td>APPROVED</td><td>WM</td><td>TITLE</td><td>SCALE</td></tr> <tr> <td>DE APPR.</td><td>DS</td><td>WEARPAD</td><td>NTS</td></tr> <tr> <td>DATE</td><td>15.09.28</td><td colspan="2">COPYRIGHT © 2006 BY DART AEROSPACE USA, INC. THIS DOCUMENT IS PROPRIETARY AND CONFIDENTIAL. AND IS SUPPLIED ON THE EXPRESS UNDERSTANDING THAT IT IS NOT TO BE USED FOR ANY PURPOSE OR COPIED OR REPRODUCED IN ANY MANNER WITHOUT WRITTEN PERMISSION FROM DART AEROSPACE USA, INC.</td></tr>


APPROVED

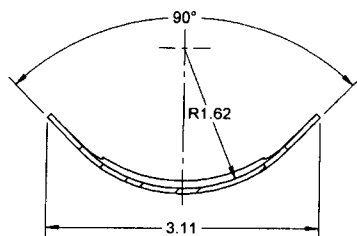


SECTION A-A

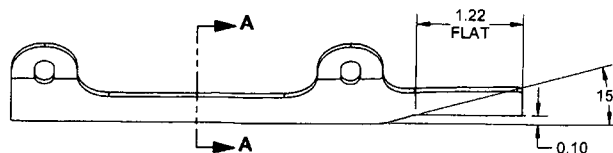

D3537-3 WEARPAD
(BENDING DETAIL)
(MAKE FROM D3537-3F)

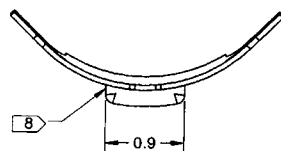

D3537-3 WEARPAD
(WELDMENT)

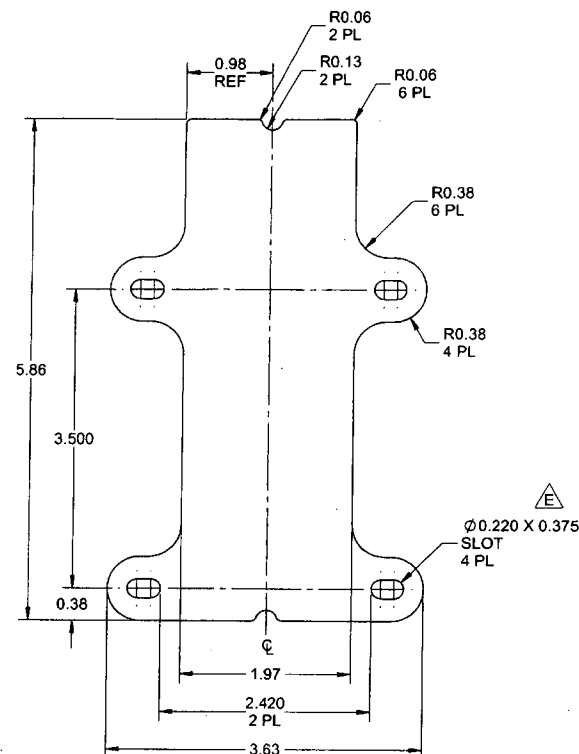

D3537-3F WEARPAD
(FLAT PATTERN)



NOTES:

- 1) MATERIAL: AISI 304/316 STAINLESS STEEL 16 GAUGE 0.063 THICK
PER MIL-S-5059 OR AMS 5513 OR 5524 OR ASTM A240 OR ASME SA240
REF DART SPEC. M304S16GA
- 2) FINISH: NONE
- 3) TOLERANCES: PER DART QSI 018 UNLESS OTHERWISE NOTED
- 4) UNITS: INCHES UNLESS OTHERWISE NOTED
- 5) BREAK SHARP EDGES: 0.005 TO 0.010 MAX
- 6) IDENTIFICATION: IDENTIFY PER QSI 044 6.1
- 7) WEIGHT: 0.50 lbs
- 8) BUILDUP HARD SURFACING 0.17 - 0.20 THICK USING 8259 ROD PER QSI 004 SECTION 4.5 (AUTOMATED WELDING) OR
BUILDUP HARD SURFACING 0.19 - 0.25 THICK USING 2059B ROD PER QSI 004 SECTION 4.1 (MANUAL WELDING)

RELEASED
2015-12-07

APPROVED

DESIGN	CB	DART AEROSPACE USA, INC.	
DRAWN	AJS	EUGENE, OR	
CHECKED	AP	DRAWING NO.	REV. E
MFG. APPR.	JLM	D3537	SHEET 2 OF 5
APPROVED	WM	TITLE	SCALE
DE APPR.	DS	WEARPAD	NTS
DATE	15.09.28	COPYRIGHT © 2005 BY DART AEROSPACE USA, INC. THIS DOCUMENT IS PRIVATE AND CONFIDENTIAL AND IS SUPPLIED ON THE EXPRESS UNDERSTANDING THAT IT IS NOT TO BE USED FOR ANY PURPOSE OR COPIED OR COMMUNICATED TO ANY OTHER PERSON WITHOUT WRITTEN PERMISSION FROM DART AEROSPACE USA, INC.	

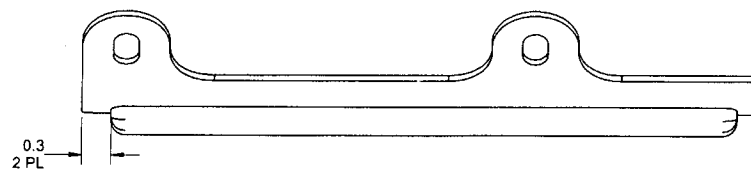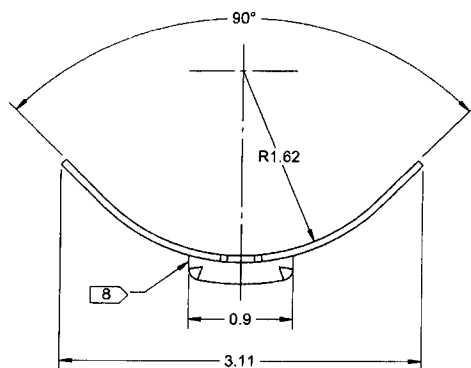

D3537-7 WEARPAD
(MAKE FROM D3537-3F)



NOTES:

- 1) MATERIAL: MAKE FROM -3F
- 2) FINISH: NONE
- 3) TOLERANCES: PER DART QSI 018 UNLESS OTHERWISE NOTED
- 4) UNITS: INCHES UNLESS OTHERWISE NOTED
- 5) BREAK SHARP EDGES: 0.005 TO 0.010 MAX
- 6) IDENTIFICATION: IDENTIFY PER QSI 044 6.1
- 7) WEIGHT: 0.50 lbs
- 8) BUILDUP HARD SURFACING 0.17 - 0.20 THICK USING 8259 ROD PER QSI 004 SECTION 4.5 (AUTOMATED WELDING) OR BUILDUP HARD SURFACING 0.19 - 0.25 THICK USING 2059B ROD PER QSI 004 SECTION 4.1 (MANUAL WELDING)

RELEASED
2015-12-07

APPROVED

DESIGN	CB	DART AEROSPACE USA, INC.	
DRAWN	AJS	EUGENE, OR	
CHECKED	AP	DRAWING NO.	REV. E
MFG. APPR.	JLM	D3537	SHEET 3 OF 5
APPROVED	WM	TITLE	SCALE
DE APPR.	DS	WEARPAD	NTS
DATE	15.09.28	COPYRIGHT © 2008 BY DART AEROSPACE USA, INC. THIS DOCUMENT IS PRIVATE AND CONFIDENTIAL AND IS SUPPLIED ON THE EXPRESS CONDITION THAT IT IS NOT TO BE USED FOR ANY PURPOSE OR COPIED OR COMMUNICATED TO ANY OTHER PERSON WITHOUT WRITTEN PERMISSION FROM DART AEROSPACE USA, INC.	

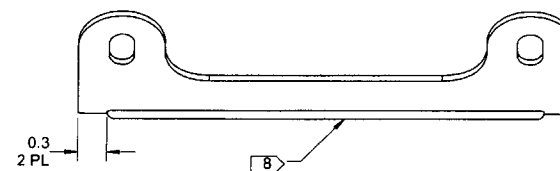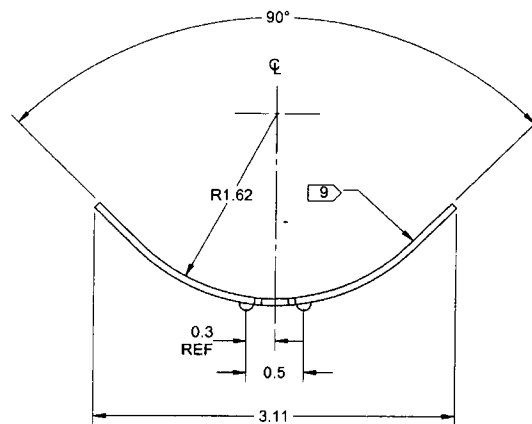

D3537-9 WEARPAD
(MAKE FROM D3537-1F)


NOTES:

- 1) MATERIAL : MAKE FROM -1F
- 2) FINISH: NONE
- 3) TOLERANCES: PER DART QSI 018 UNLESS OTHERWISE NOTED
- 4) UNITS: INCHES UNLESS OTHERWISE NOTED
- 5) BREAK SHARP EDGES: 0.005 TO 0.010 MAX
- 6) IDENTIFICATION: IDENTIFY PER QSI 044 6.1
- 7) WEIGHT: 0.19 lbs
- 8) APPLY HARD SURFACING WELD BEAD 0.06 - 0.13 THICK USING 8259 ROD PER QSI 004 SECTION 4.5 (AUTOMATED WELDING) OR
APPLY HARD SURFACING WELD BEAD 0.06 - 0.13 THICK USING 2059B ROD PER QSI 004 SECTION 4.1 (MANUAL WELDING)
- 9) COAT ENTIRE TOP (CONCAVE) SURFACE WITH TEXTURED COATING, 0.02-0.04 THICK, PER DART QSI 005 4.9


RELEASED
2015-12-07

APPROVED



DESIGN	CB	DART AEROSPACE USA, INC.	
DRAWN	AJS	EUGENE, OR	
CHECKED	AP	DRAWING NO.	REV. E
MFG. APPR.	JLM	D3537	SHEET 4 OF 5
APPROVED	WM	TITLE	SCALE
DE APPR.	DS	WEARPAD	NTS
DATE	15.09.28	COPYRIGHT © 2006 BY DART AEROSPACE USA, INC. THIS DOCUMENT IS PRIVATE AND CONFIDENTIAL AND IS SUPPLIED ON THE EXPRESS CONDITION THAT IT IS NOT TO BE USED FOR ANY PURPOSE OR COPIED OR COMMUNICATED TO ANY OTHER PERSON WITHOUT WRITTEN PERMISSION FROM DART AEROSPACE USA, INC.	

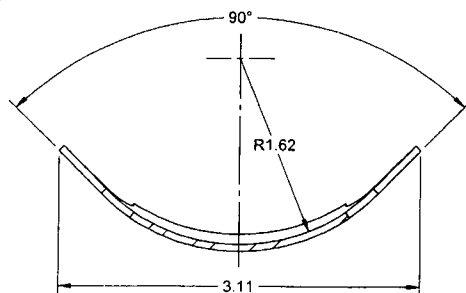

SECTION B-B

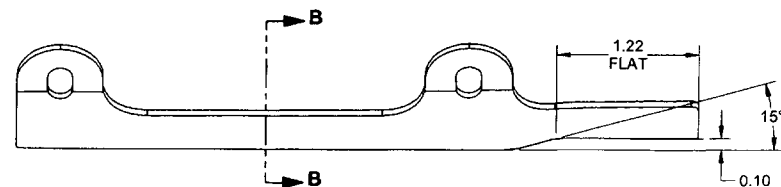

D3537-11 WEARPAD
(BENDING DETAIL)
(MAKE FROM D3537-3F)

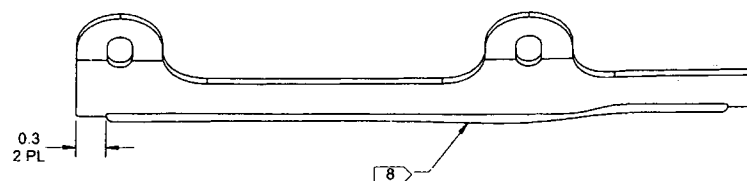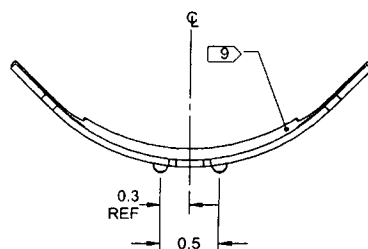

D3537-11 WEARPAD
(WELDMENT)

NOTES:

- 1) MATERIAL: MAKE FROM -3F
- 2) FINISH: NONE
- 3) TOLERANCES: PER DART QSI 018 UNLESS OTHERWISE NOTED
- 4) UNITS: INCHES UNLESS OTHERWISE NOTED
- 5) BREAK SHARP EDGES: 0.005 TO 0.010 MAX
- 6) IDENTIFICATION: IDENTIFY PER QSI 044 6.1
- 7) WEIGHT: 0.25 lbs
- 8) APPLY HARD SURFACING WELD BEAD 0.06 - 0.13 THICK USING 8259 ROD PER QSI 004 SECTION 4.5 (AUTOMATED WELDING) OR APPLY HARD SURFACING WELD BEAD 0.06 - 0.13 THICK USING 2059B ROD PER QSI 004 SECTION 4.1 (MANUAL WELDING)
- 9) COAT ENTIRE TOP (CONCAVE) SURFACE WITH TEXTURED COATING, 0.02-0.04 THICK, PER DART QSI 005 4.9

RELEASED
2015-12-07

APPROVED

DESIGN CB			DART AEROSPACE USA, INC. EUGENE, OR	
DRAWN AJS				
CHECKED AP	DRAWING NO. D3537		REV. E	
MFG. APPR. JLM			SHEET 5 OF 5	
APPROVED WM			SCALE	
DE APPR. DS	WEARPAD		NTS	
DATE 15.09.28		COPYRIGHT © 2006 BY DART AEROSPACE USA, INC. THIS DOCUMENT IS PRIVATE AND CONFIDENTIAL AND IS SUPPLIED ON THE EXPRESS CONDITION THAT IT IS NOT TO BE USED FOR ANY PURPOSE OR COPIED OR COMMUNICATED TO ANY OTHER PERSON WITHOUT WRITTEN PERMISSION FROM DART AEROSPACE USA, INC.		

REV. E
SHEET 5 OF 5

ENGINEERING CHANGE NOTICE **DART AEROSPACE LTD**

Date:	15.12.07	Job No.:		ADR Yes/No:	N	ADR Date:		ECN #:	15- 650
Product No.:	D119-646	Created By:	DB	Approved By:	MA				
Product Name:	SKIDTUBE INSTALLATION			Checked By:	MA				

Distribution	Reqd	Resp	Initial / Date (YY/MM/DD)
Director of Operations	N		
Production Manager / Coord.	Y	MP / MF	YME 15-12-10
Purchasing Manager / Purchasing Coord.	N	LL / CL	
Production Engineering Coord.	Y	DD / JLM	15-12-10
Production Engineering Coord.	N	DL	
Customer Order Processing	N	SL / BG	

Distribution	Reqd	Resp	Initial / Date (YY/MM/DD)
DQA / QA Coord.	Y	PS / ED	15/12/10
QC Coordinator	Y	PD	15.12.10
Customer Support	Y	SW / LM	15.12.10
Customer Technical Support	Y	MB / HS	15.12.10
Marketing	N	SL / WR	
Sales Support Manager	N	CP	

Reason for Change: ADD D5101-7 CROSSBOLT SPACER, D5101-047 CROSSBOLT SPACER ASSY

Documents Affected:
D5101 REV B,

IF APPLICABLE: **NCR:** _____ **PAR:** _____ **CAR:** _____ **CIR:** _____ **URF:** 15-560

PAPERWORK UPDATE ☐ **PARTS MUST COMPLY** ☒ **PREVIOUS PARTS SATISFACTORY** ☐


#	Quality Assurance Actions	Reqd	Resp	Notes	Complete
1	Notify Previous Customers	N			
2	Notify Eurocopter France	N			
3	Notify Augusta Westland	N			
4	Manufacturing Licensing Agreement Update	N			

#	Engineering Actions	Reqd	Resp	Notes	Complete
5	Required Documents/Drawings/Item ID's Under Review (URF)	N			
6	Update Master Document List (MDL)	N			
7	Update Document Record (DR)	N			
8	Update Product Compatability Matrix	N			
9	Notify TC / FAA of Change (eg. ICA, 8110-3)	N			
10					

#	Document Control Actions	Reqd	Resp	Notes	Complete
11	Move / Update Electronic Files / Design Journal	Y	KJ		15.12.10
12	Update Product Specification Files (Bluefiles)	N			
13	Update Approved/Preliminary Dwg PDF Files	Y	KJ		15.12.10
14	Update Product Development Summary (STC applications)	N			
15	Update QSI 021 (TC/FAA STC) and/or STC Approval List	N			
16	Create/Update Parts / STC Database	Y	KJ		15.12.10
17	Update / Verify Airworthiness Release Certificate Database	Y	KJ		15.12.10
18	Create / Update Change Record Form / Item Card Database	N			
19	Create / Update Packaging Process Plan (PPP)	N			
20	Red Decals required on Packaging Process Plan (PPP)?	N			
21	Update Controlled Supplier Documents (Qpulse) Database	N			
22	Update Grey Project Binder / Electronic Project Folder	N			
23	Update D-Part / M-Drawing / DSI / DEO Master Binders	Y	KJ		15.12.10
24	Update "Royalty Paid to" attribute (Parts sold under Dart USA STC's)	N			
25					

Description / Action:

RELEASE DRAWING D5101 TO ALLOW -7/-047 PRODUCTION. RELATED DOCUMENT REVISIONS (MDL, IIN, TO BE RELEASED ON EC 15-560)

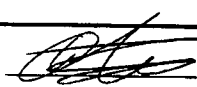ECN Verified & Complete:  Date: DEC 15 2015